



IMPORTANT – THIS COMMUNICATION AFFECTS YOUR PROPERTY

COUNCIL OF THE ISLES OF SCILLY

Town Hall, St Mary's TR21 0LW
Telephone: 01720 424455 – Email: planning@scilly.gov.uk

Town and Country Planning Act 1990
Town and Country Planning (Development Management Procedure) Order 2010

PERMISSION FOR VARIATION OF CONDITION

Application No: P/20/086/ROV

Date Application Registered: 26th October 2020

Applicant: Council Of The Isles Of Scilly
Town Hall
The Parade
St Mary's
Isles Of Scilly
TR21 0LW

Agent: Mr Jim Wrigley
9/10 Offices
Porthmellon Enterprise Centre
1 - 4 Porthmellon Industrial Estate
Porth Mellon
St Mary's
Isles Of Scilly
TR21 0JY

Site address: Land Opposite Telegraph Tower Telegraph Road Telegraph St Mary's Isles Of Scilly.

Proposal: Variation of condition C2 (Approved Plans) of planning permission P/20/037/FUL (Installation of electric vehicle charge point providing charging for two electric charging bays) in order to add an additional electric vehicle to grid charger at the site.

In pursuance of their powers under the above Act, the Council hereby **PERMIT** the above development to be carried out in accordance with the varied plans as set out in condition 2 below. **All other conditions, where they are capable of taking affect remain in place as per the decision notice P/20/037/FUL.**

P/20/037/FUL Condition 2 as amended.

C2 The development hereby permitted shall be carried out in accordance with the approved details only including:

- **Location Plan;**
- **Block Plan;**
- ~~Layout Plan;~~
- ~~Proposed Elevation Plan, Drawing Number: GO-EV Site 21~~
- **Proposed Layout Plan, Drawing Number: GO-EV Site 21 Layout Plans, Revision 04, dated 23/10/2020**
- **Proposed Elevation Plan, Drawing Number GO-EV Site 21 Elevations, Revision 03, dated 23/10/2020**

These are stamped as APPROVED

Reason: For the clarity and avoidance of doubt and in the interests of the character and appearance of the Conservation Area, Area of Outstanding Natural Beauty and Heritage Coast in accordance with Policy 1 of the Isles of Scilly Local Plan 2005.

Please retain a copy of this notice together with the approved Decision Notice P/20/037/FUL which includes all other conditions and informatives.

Signed: 

Senior Officer, Planning and Development Management


Duly Authorised Officer of the Council to make and issue Planning Decisions on behalf of the Council of the Isles of Scilly.

DATE OF ISSUE: 8th December 2020

RECEIVED
By A King at 12:09 pm, Oct 26, 2020

APPROVED
By Lisa Walton at 1:27 pm, Dec 08, 2020

Approximate height of wall behind installation shown for reference

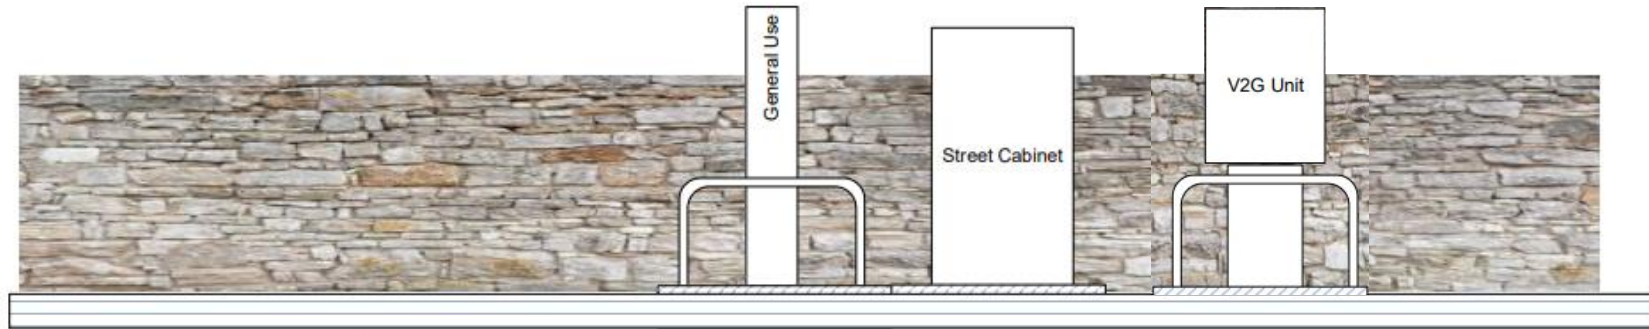

Hard Surfacing Layer
(Existing tarmac)

Title	IoS GO-EV Site Elevations
-------	---------------------------

Notes
Diagram showing front elevation of Site 21 installation with associated EV charging and supply equipment.

Project	IoS GO-EV
Client	IoSCV
Date	23/10/2020
Scale	1:25
Drawn	DJH
Drawing	GO-EV Site 21 Elevations
Revision	03

Designed By




Email: info@ioscv.co.uk
Web: www.ioscv.co.uk

RECEIVED

By A King at 12:10 pm, Oct 26, 2020

APPROVED

By Lisa Walton at 1:27 pm, Dec 08, 2020

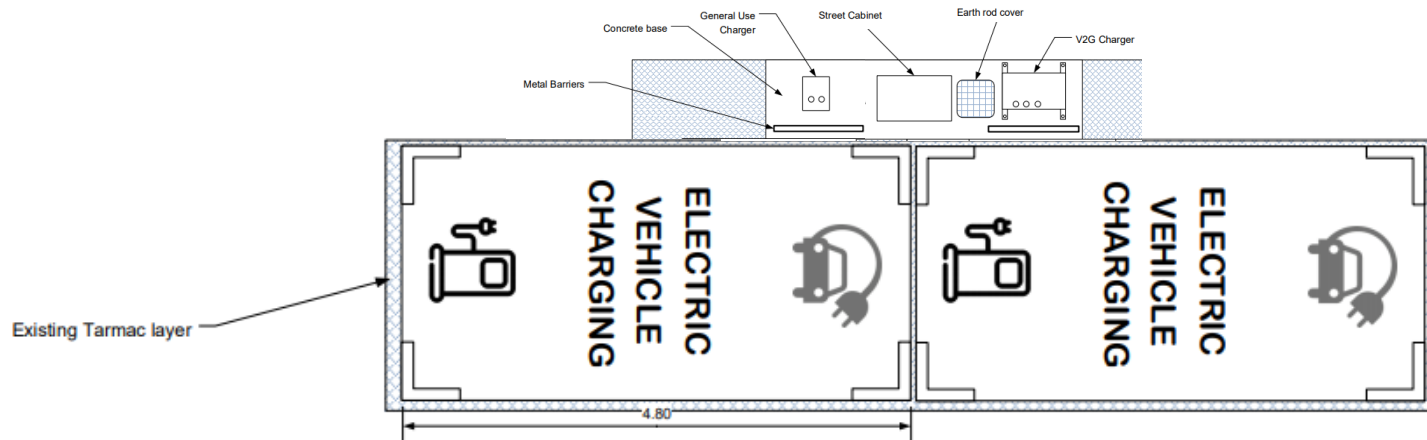

Title IoS GO-EV Layout Plans

Notes

Diagram showing EV car parking layouts with charging and supply equipment..



Project	IoS GO-EV
Client	IoSCV
Date	23/10/2020
Scale	1:50
Drawn	DJH
Drawing	GO-EV Site 21 Layout Plans
Revision	04

Designed By



Email: info@ioscv.co.uk
Web: www.ioscv.co.uk