

RECEIVED


By A King at 9:12 am, Jun 07, 2023

East Elevation

Scale 1:50

Mr & Mrs Stevens
2 Matthews Field
Church Road
St Mary's
Isles of Scilly

JMS2

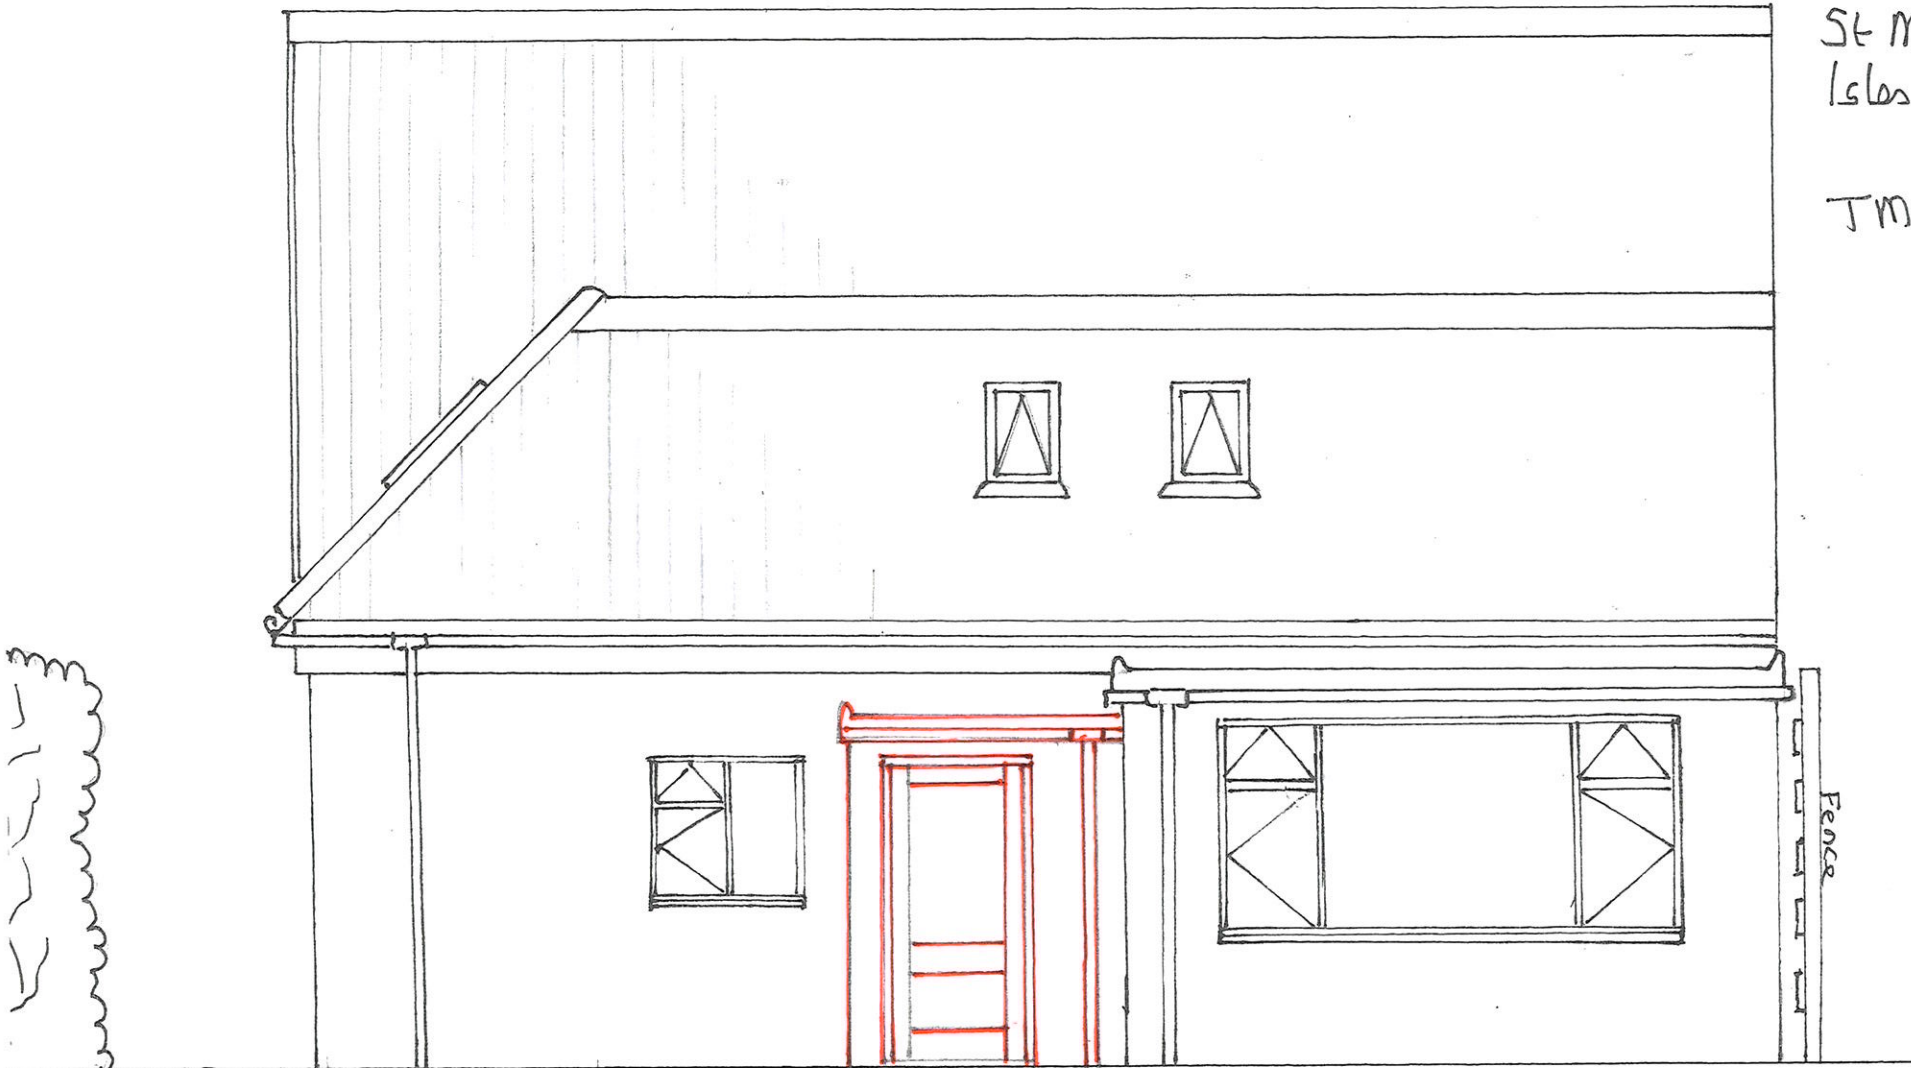

Hedge

Existing elevation with Proposed Porch shown in **Red ink**. This elevation is the same without the Porch as the existing back door currently occupies the same relative position - it is just 1.8m further back. See: ground floor Plan.

Fence