
Application Site outlined in red

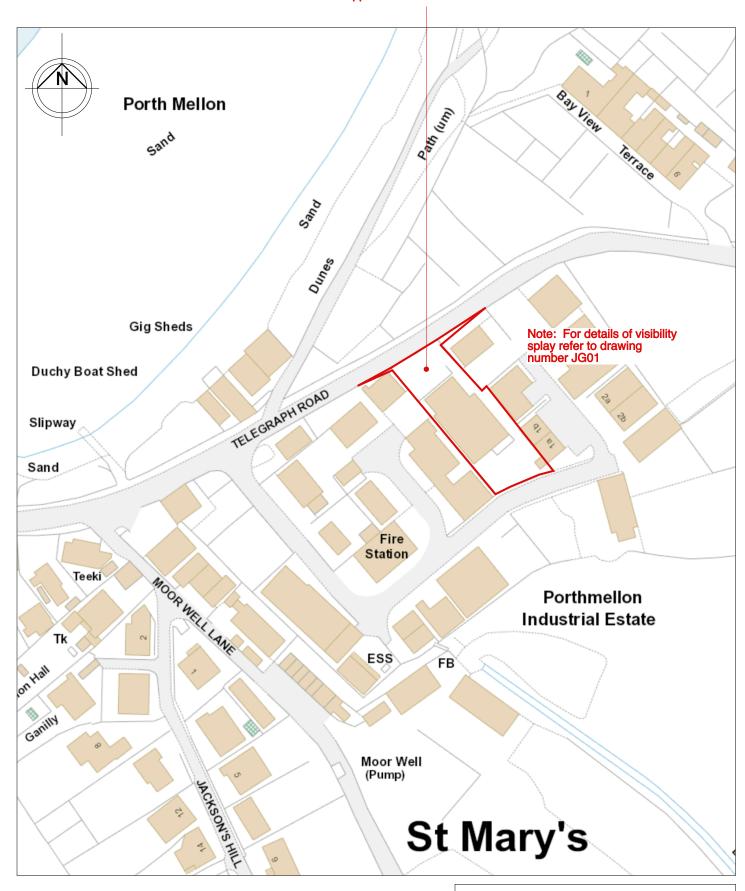

Location Plan Scale 1:1250 @ A3 Note: OS Map reproduced under 'Landmark' Paper Map Copy Licence (PMCL) number 670690383.708409



Aerial Photo



Block Plan Scale 1:500 @ A3

NOTES

- THIS DRAWING IS THE COPYRIGHT OF THE ARCHITECT AND MAY NOT BE REPRODUCED WITHOUT LICENCE
- 2 DO NOT SCALE OFF THIS DRAWING
- ALL DIMENSIONS AND LEVELS ARE TO BE CHECKED ON SITE BY THE CONTRACTOR BEFORE COMMENCEMENT OF WORK AND ANY DISCREPENCIES REPORTED TO THE ARCHITECT
- 4 NO RESPONSIBILITY CAN BE ACCEPTED FO ERRORS ARISING ON SITE DUE TO UNAUTHORISED VARIATIONS FROM THE

AMENDMENTS

- A OS Map licence number added AKB 081019
- Red line boundary changed to include visibility splay MRB 201219

PLANNING

Studio St Ives 4 Gabriel Street St Ives TR26 2LU 01736 798427

01736 798427 MIKE BRADBURY

PZ

DESIGN

Alterations to Scillonia Building Supplies, St Mary's, The Isles of Scilly

for Wright Construction

Location & Block Plan


1977-P01 B

E

As shown@A3 July 2019

OFFICE USE / PRE-ISSUE